


Plat Book No. 10 Page 391
 Filed in the Clerk's Office, Circuit Court, York Co., Va.
 the 25th day of August 1987
 Teste:



Edith M. Elliott, Clerk

Carl Drosselmeier D.C.
 DB 494 page 404 2:22 P.M.

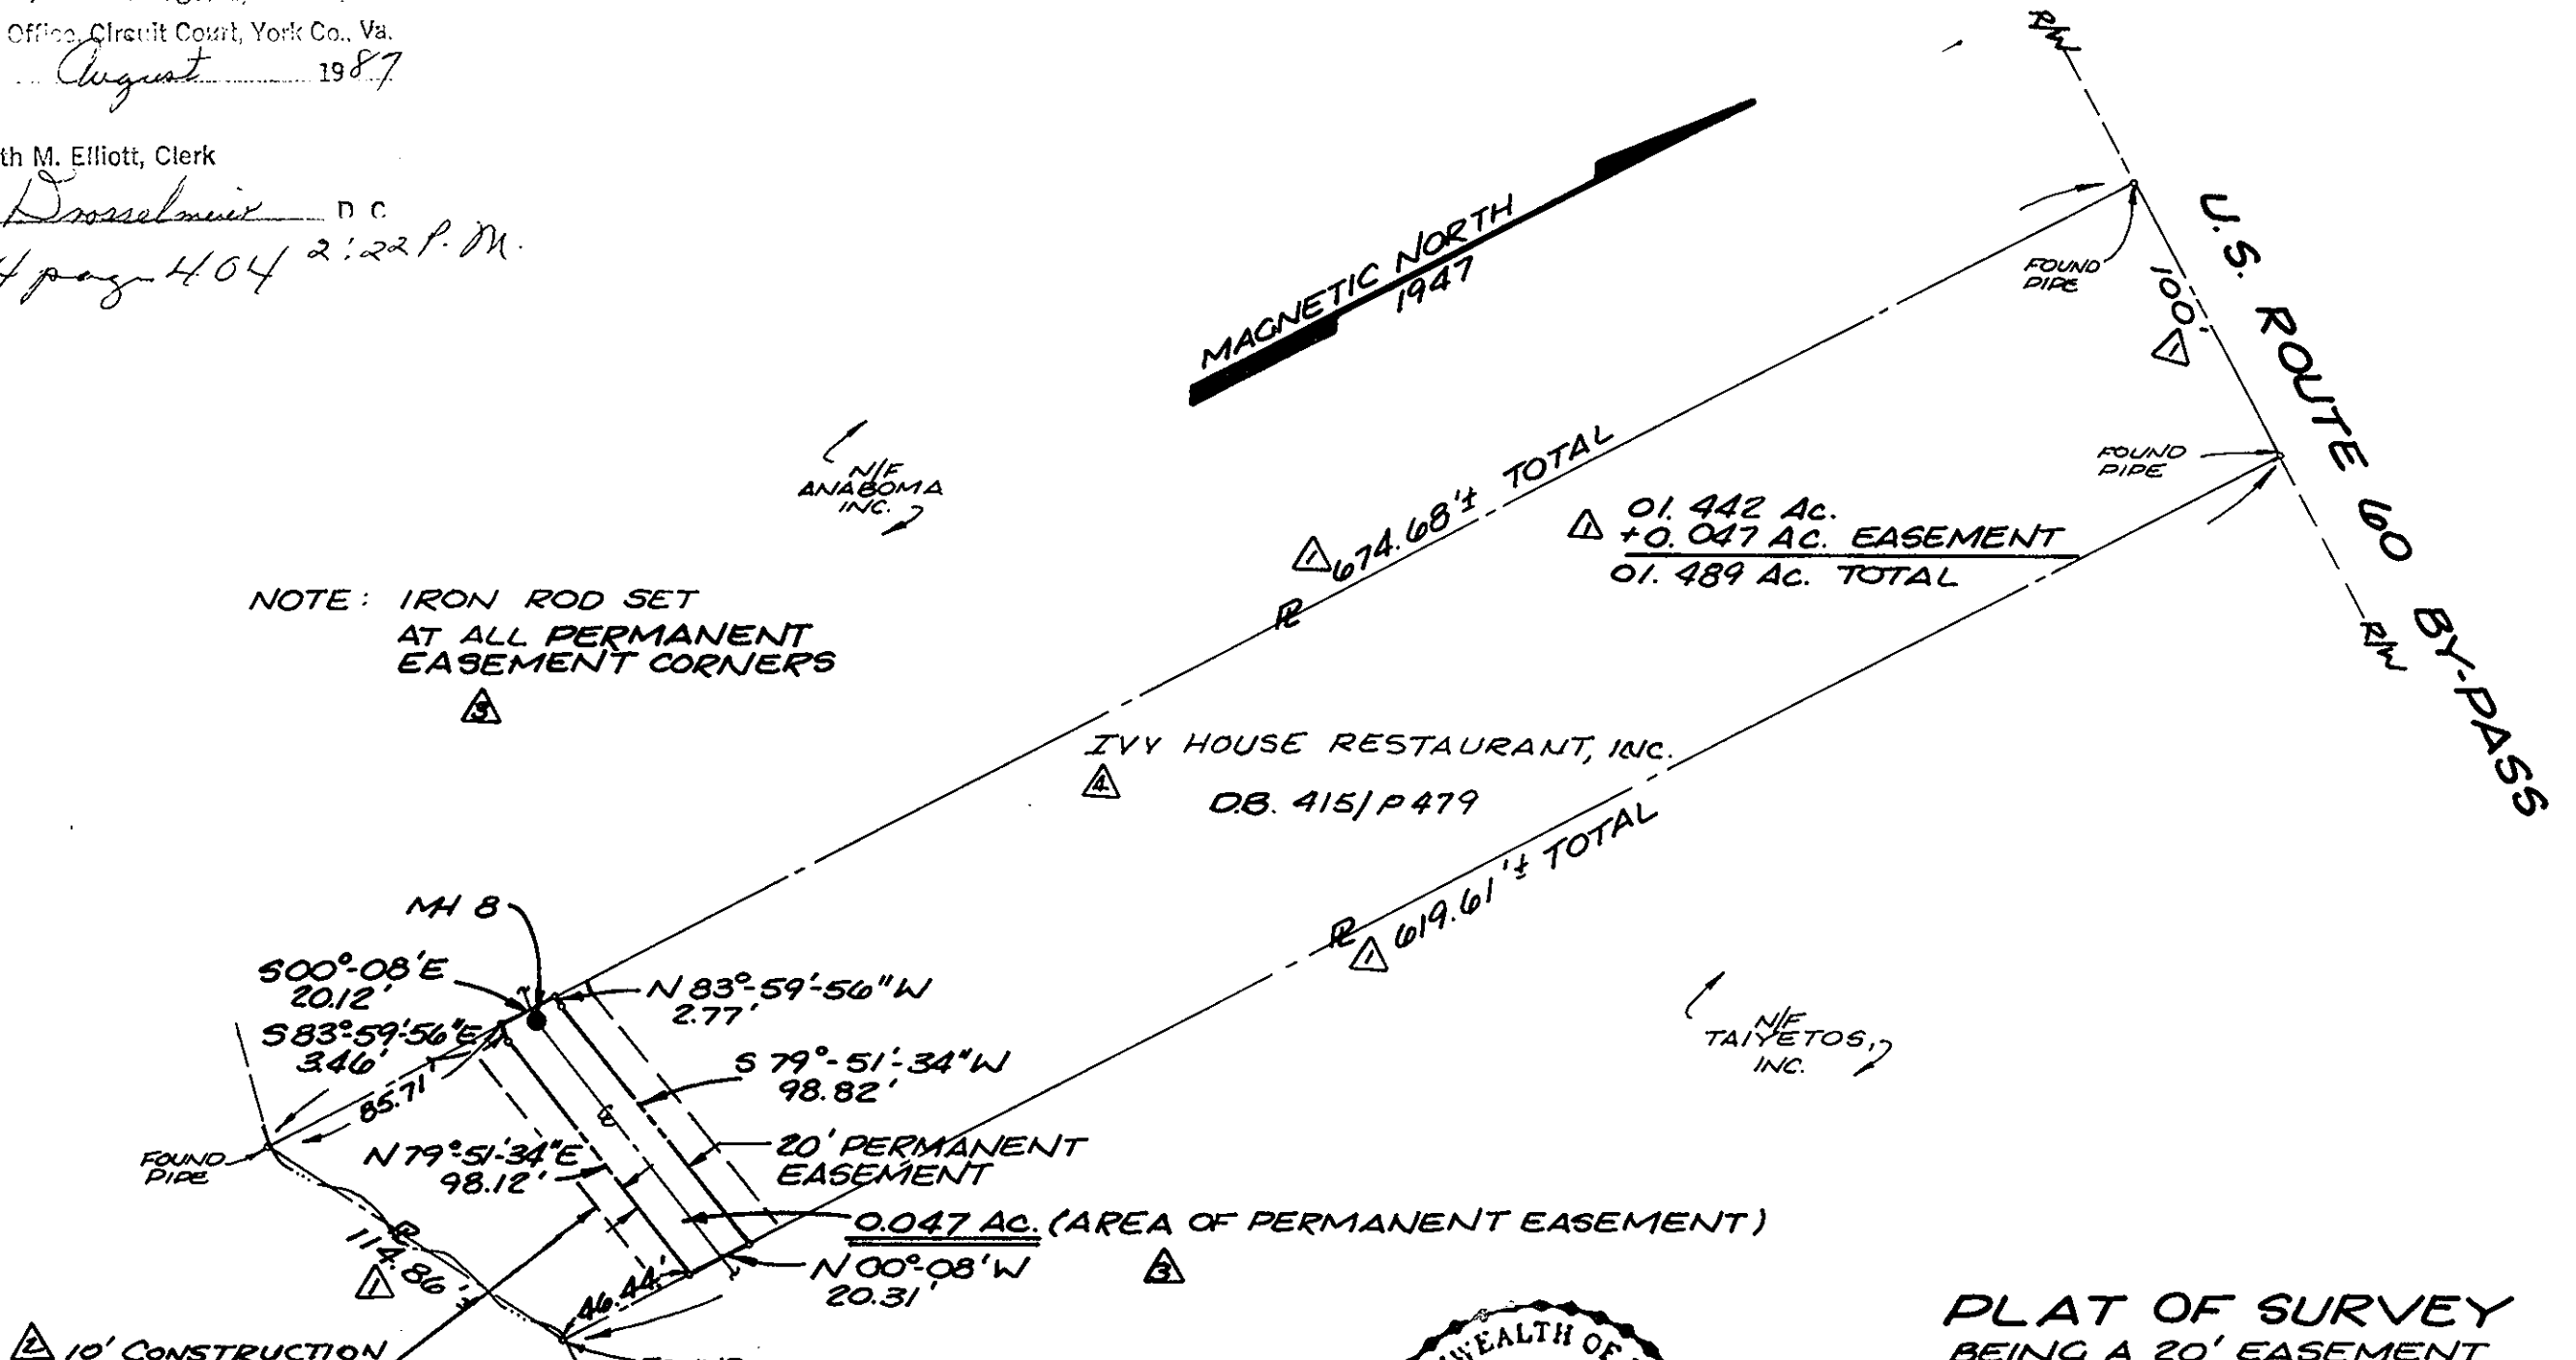

NOTE: IRON ROD SET
 AT ALL PERMANENT
 EASEMENT CORNERS

IVY HOUSE RESTAURANT, INC.
 DB. 415/P 479

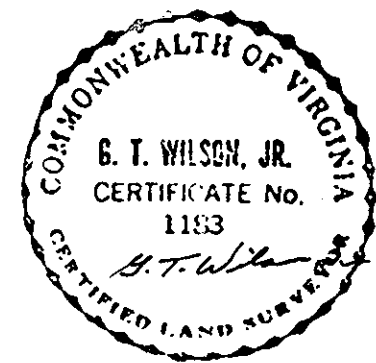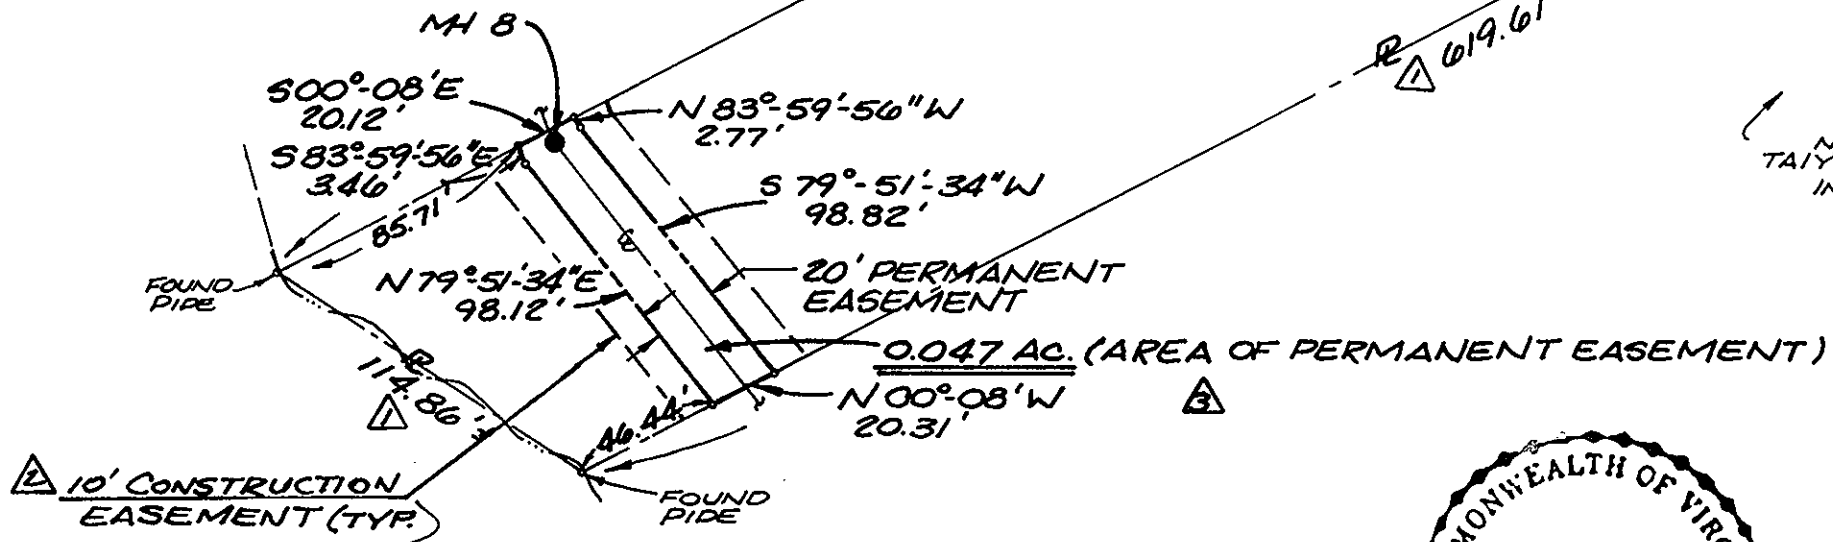

PLAT OF SURVEY
 BEING A 20' EASEMENT
 THROUGH THE LAND OF
 IVY HOUSE RESTAURANT, INC.
 BRUTON DISTRICT YORK COUNTY, VA

- △ ~~CLT~~ 5/11/87 REV.-CHANGE OF OWNER
- △ ~~CLT~~ 4/29/83 REV. NOTE & ADDED AC. NOTE

REVISIONS	NO.	SYMBL.	BY	DATE	DESCRIPTION	SCALE	DES.	BUCHART-HORN, INC. Consulting Engineers & Planners YORK, PA. HARRISBURG, PA. WASHINGTON, D.C. LEWISBURG, PA. BALTIMORE, MD. MEMPHIS, TENN. VERO BEACH, FLA. NEW ORLEANS, LA. WILLIAMSBURG, VA. CHARLESTON, W.VA.	JOB NO. 90145-89
						1"=60'			
			TLS	4/29/83	ADDED CONSTRUCTION ESMT.				
			CLT	4/4/83	REV. TO SHOW TOTAL DIST. & TOTAL AREA				